


KEYED NOTES

1. NEW 210 CEILING ROOM, THIS AREA
2. EXPOSED CEILING
3. NEW FLAT CEILING ROOM
4. EXISTING TO REMAIN
5. NO EXISTING CEILING

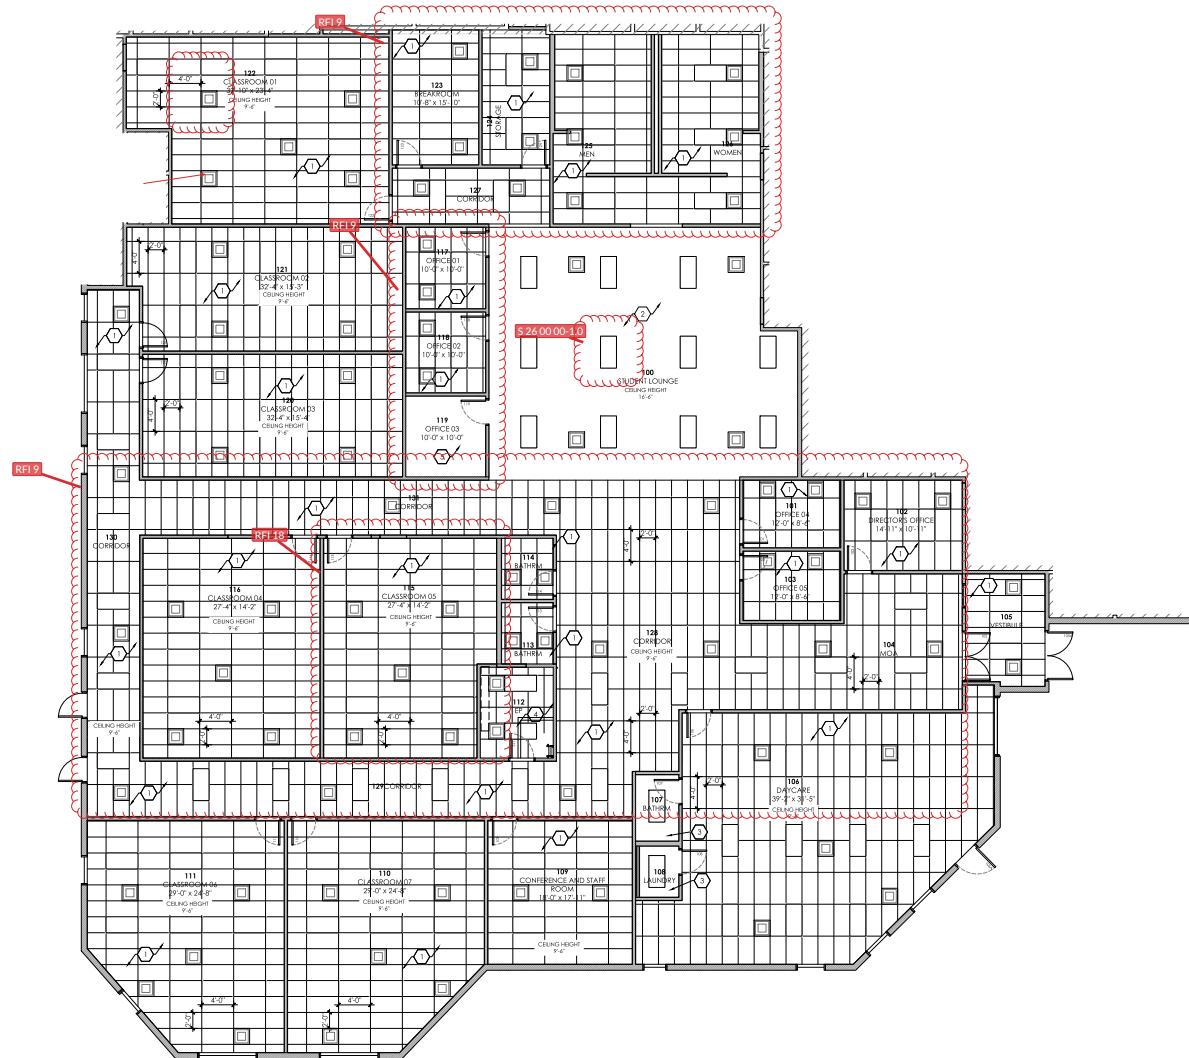

1
A.05

REFLECTED CEILING PLAN

SCALE 1/8"=1'-0"

Project

GOODWILL BART

940 N MARR ROAD
COLUMBUS, IN 47201

ISSUE DATE

No. Date Issued

COPYRIGHT:

ALLEATO GROUP

PROJ. MANAGER:

B.C.

RCP FLOOR PLAN
Main level

A.05

ALLEATO
GROUP
Your partner from the ground up.

8335 Cross Street, Ste 100,
Indianapolis, IN 46250
www.alleatogroup.com
T: 317.762.0000

ALLEGATO AND/OR DUPLICATION OF THE
SPECS ARE THE PROPERTY OF THE
OWNER AND ALLEGATO GROUP, LLC.